
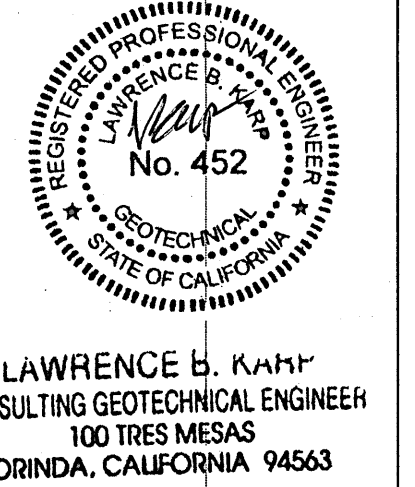
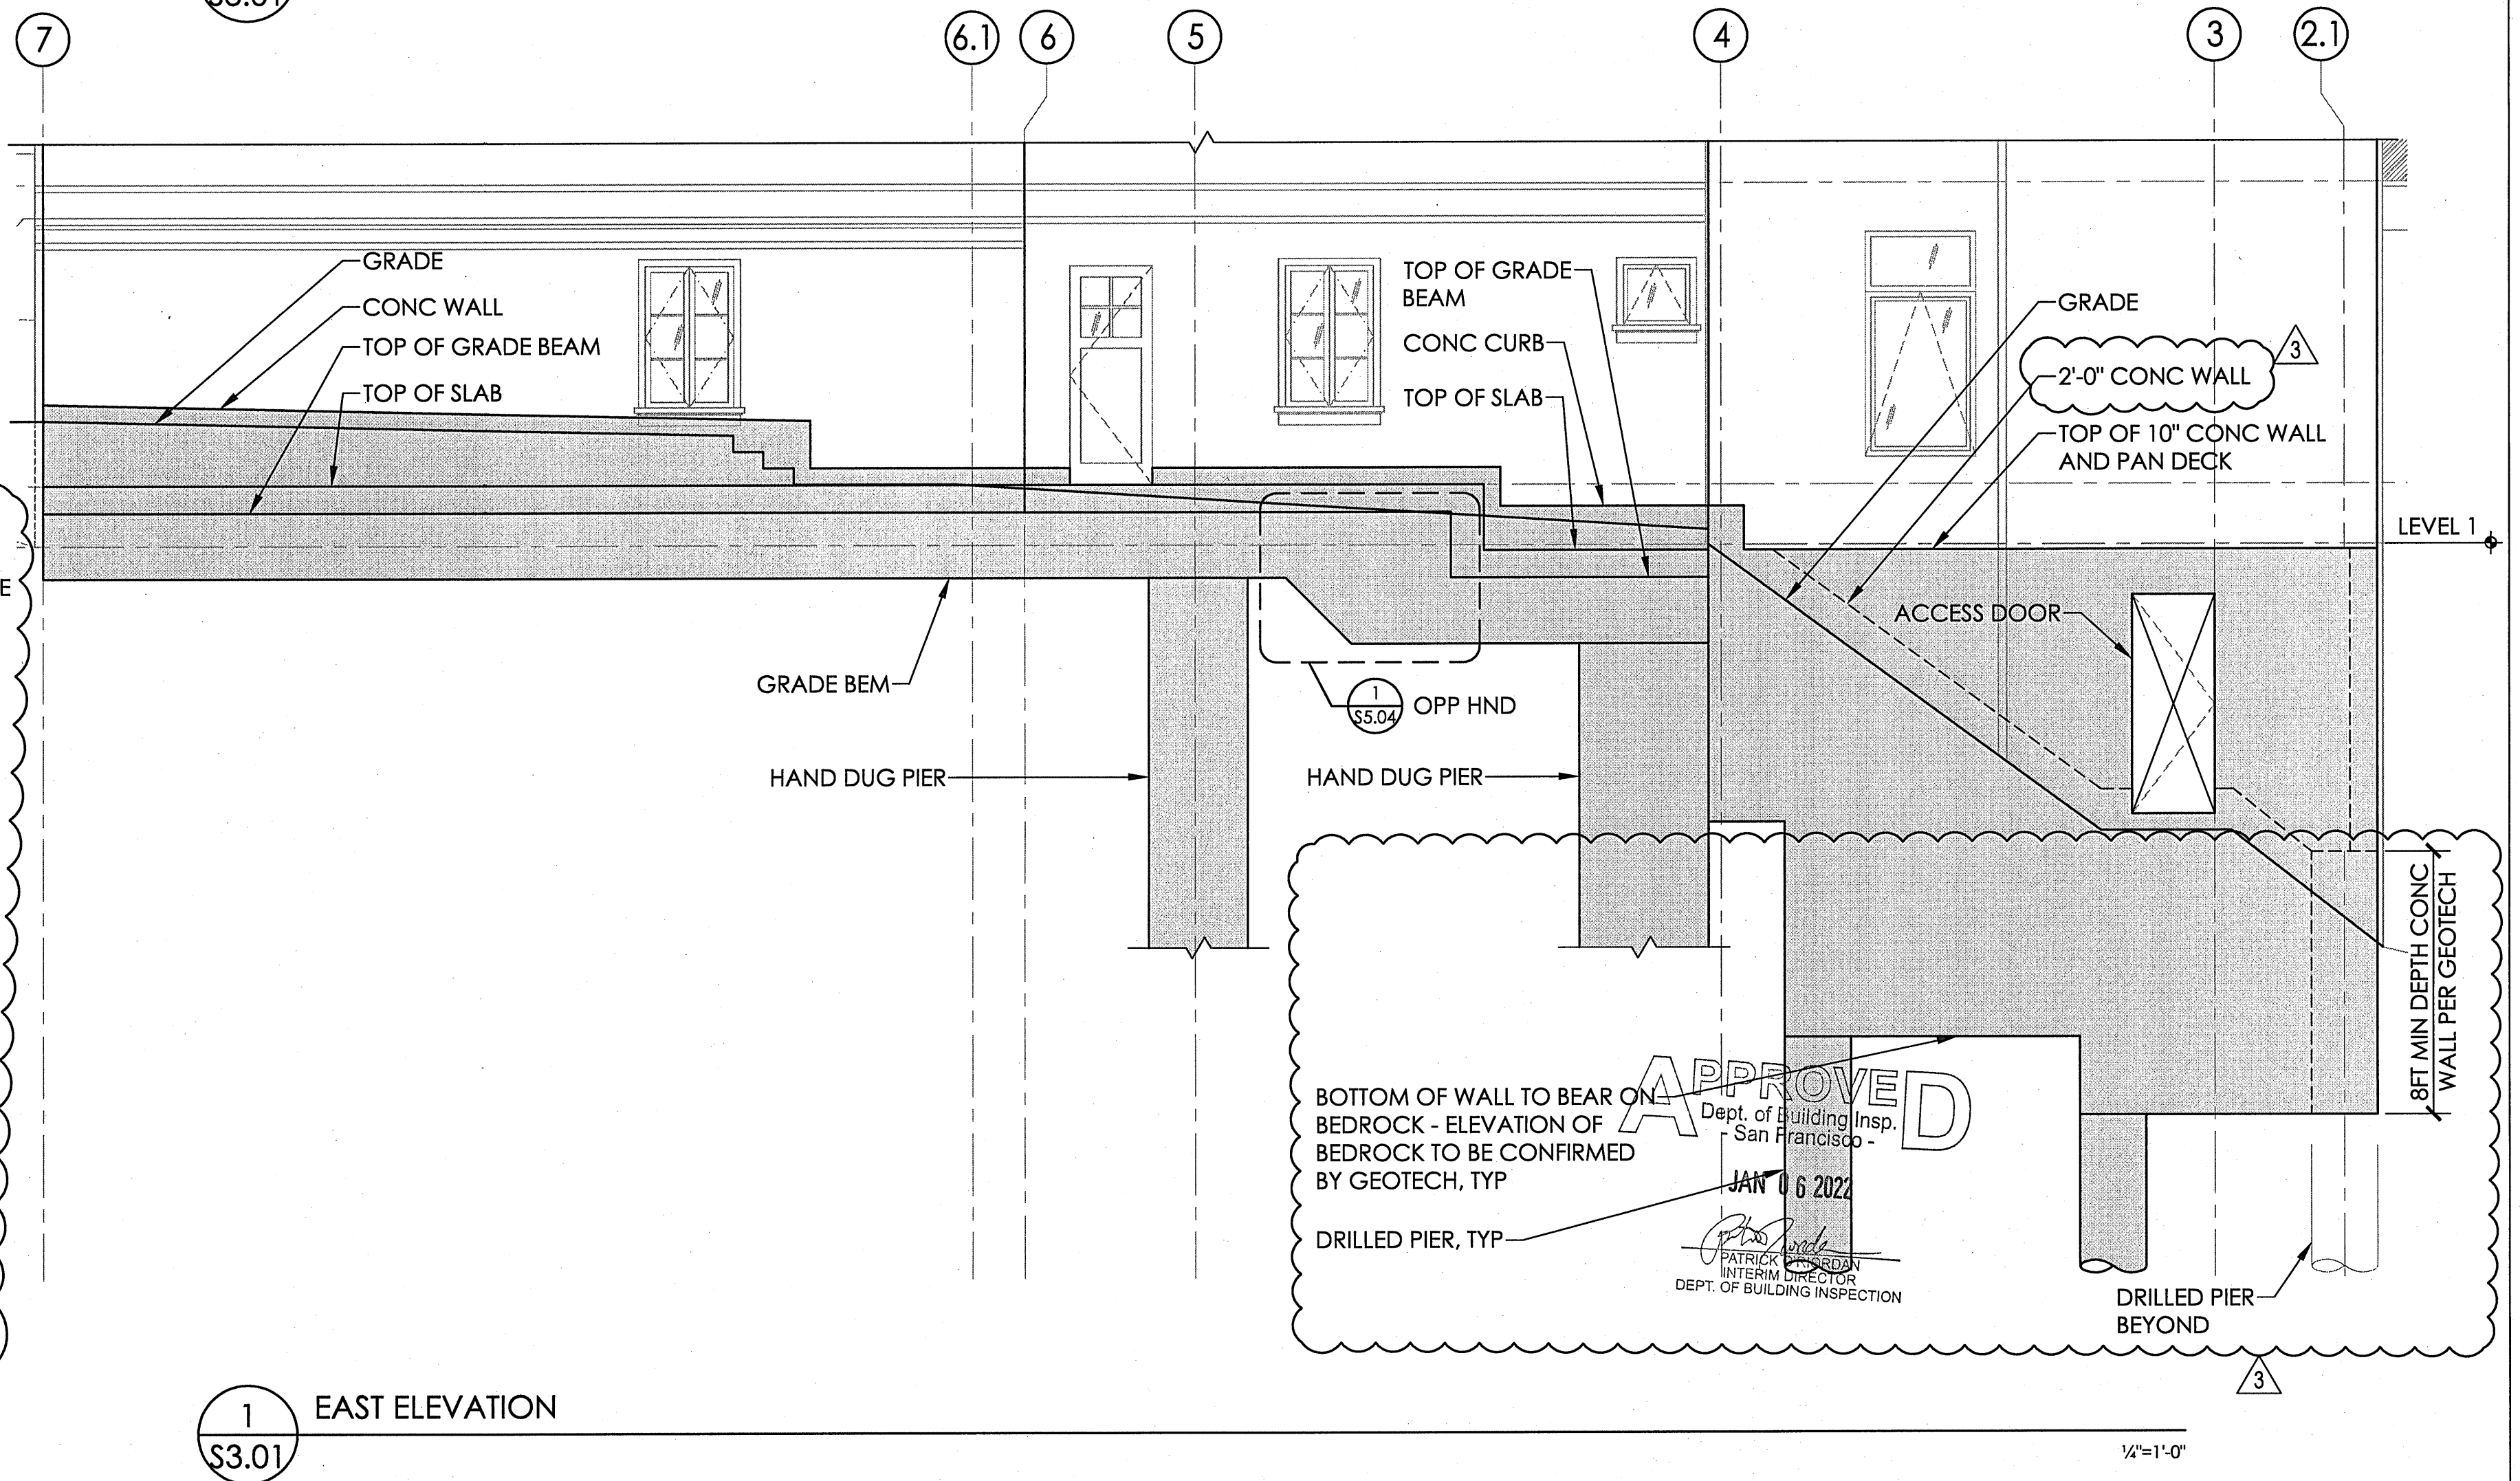
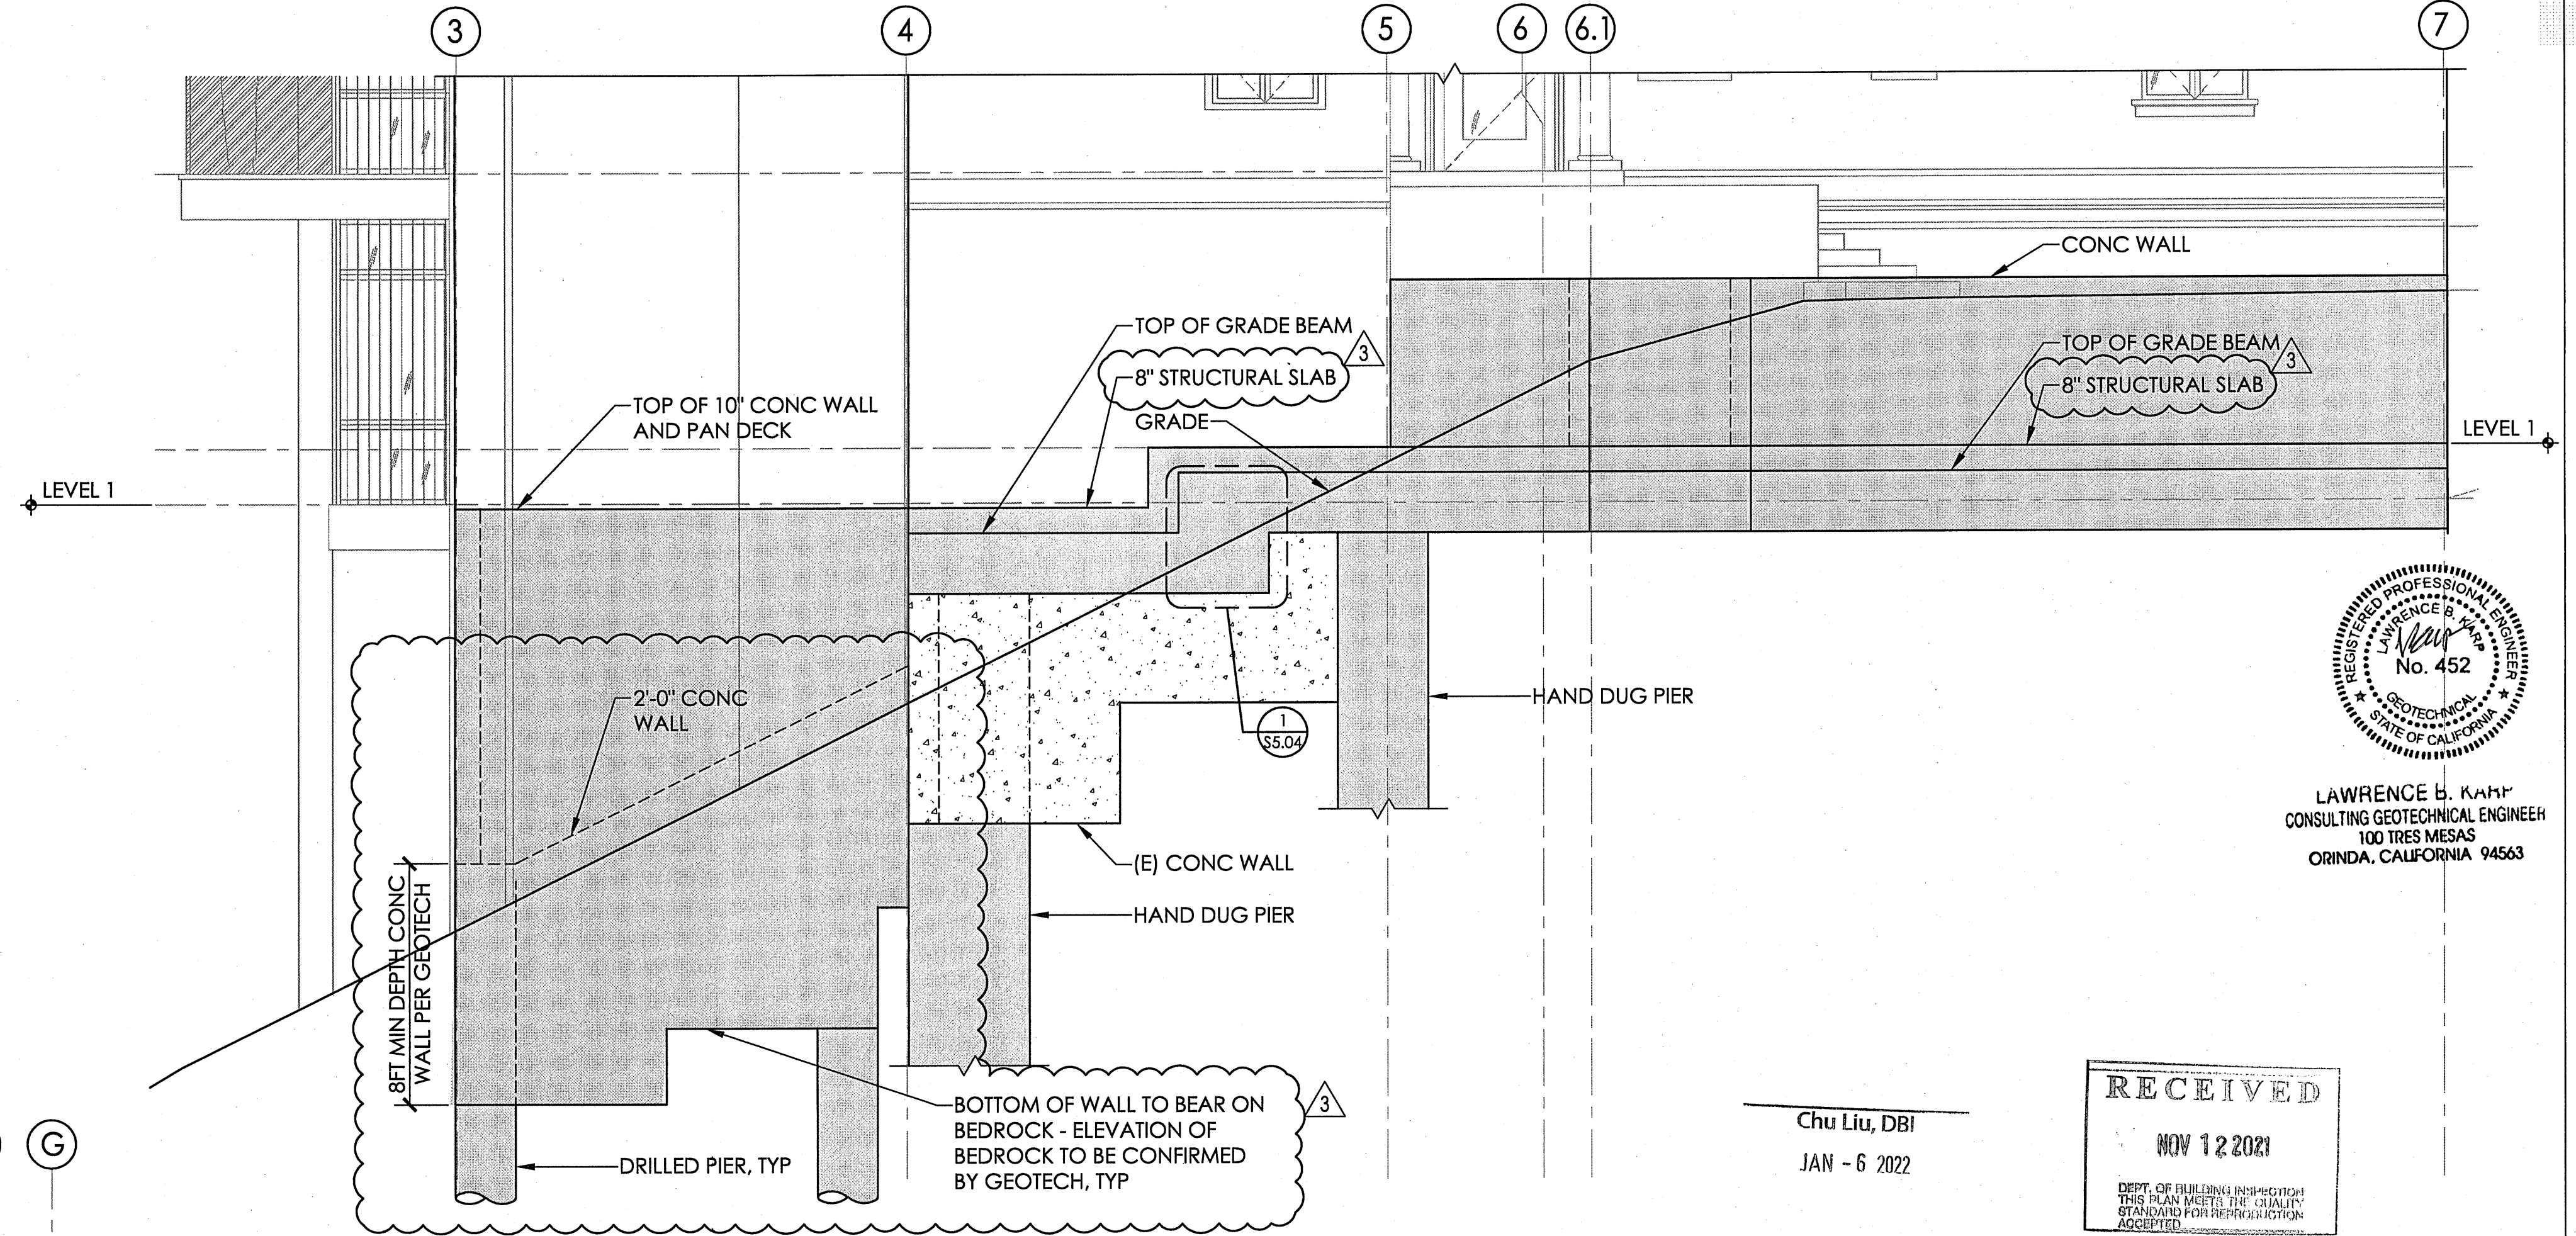
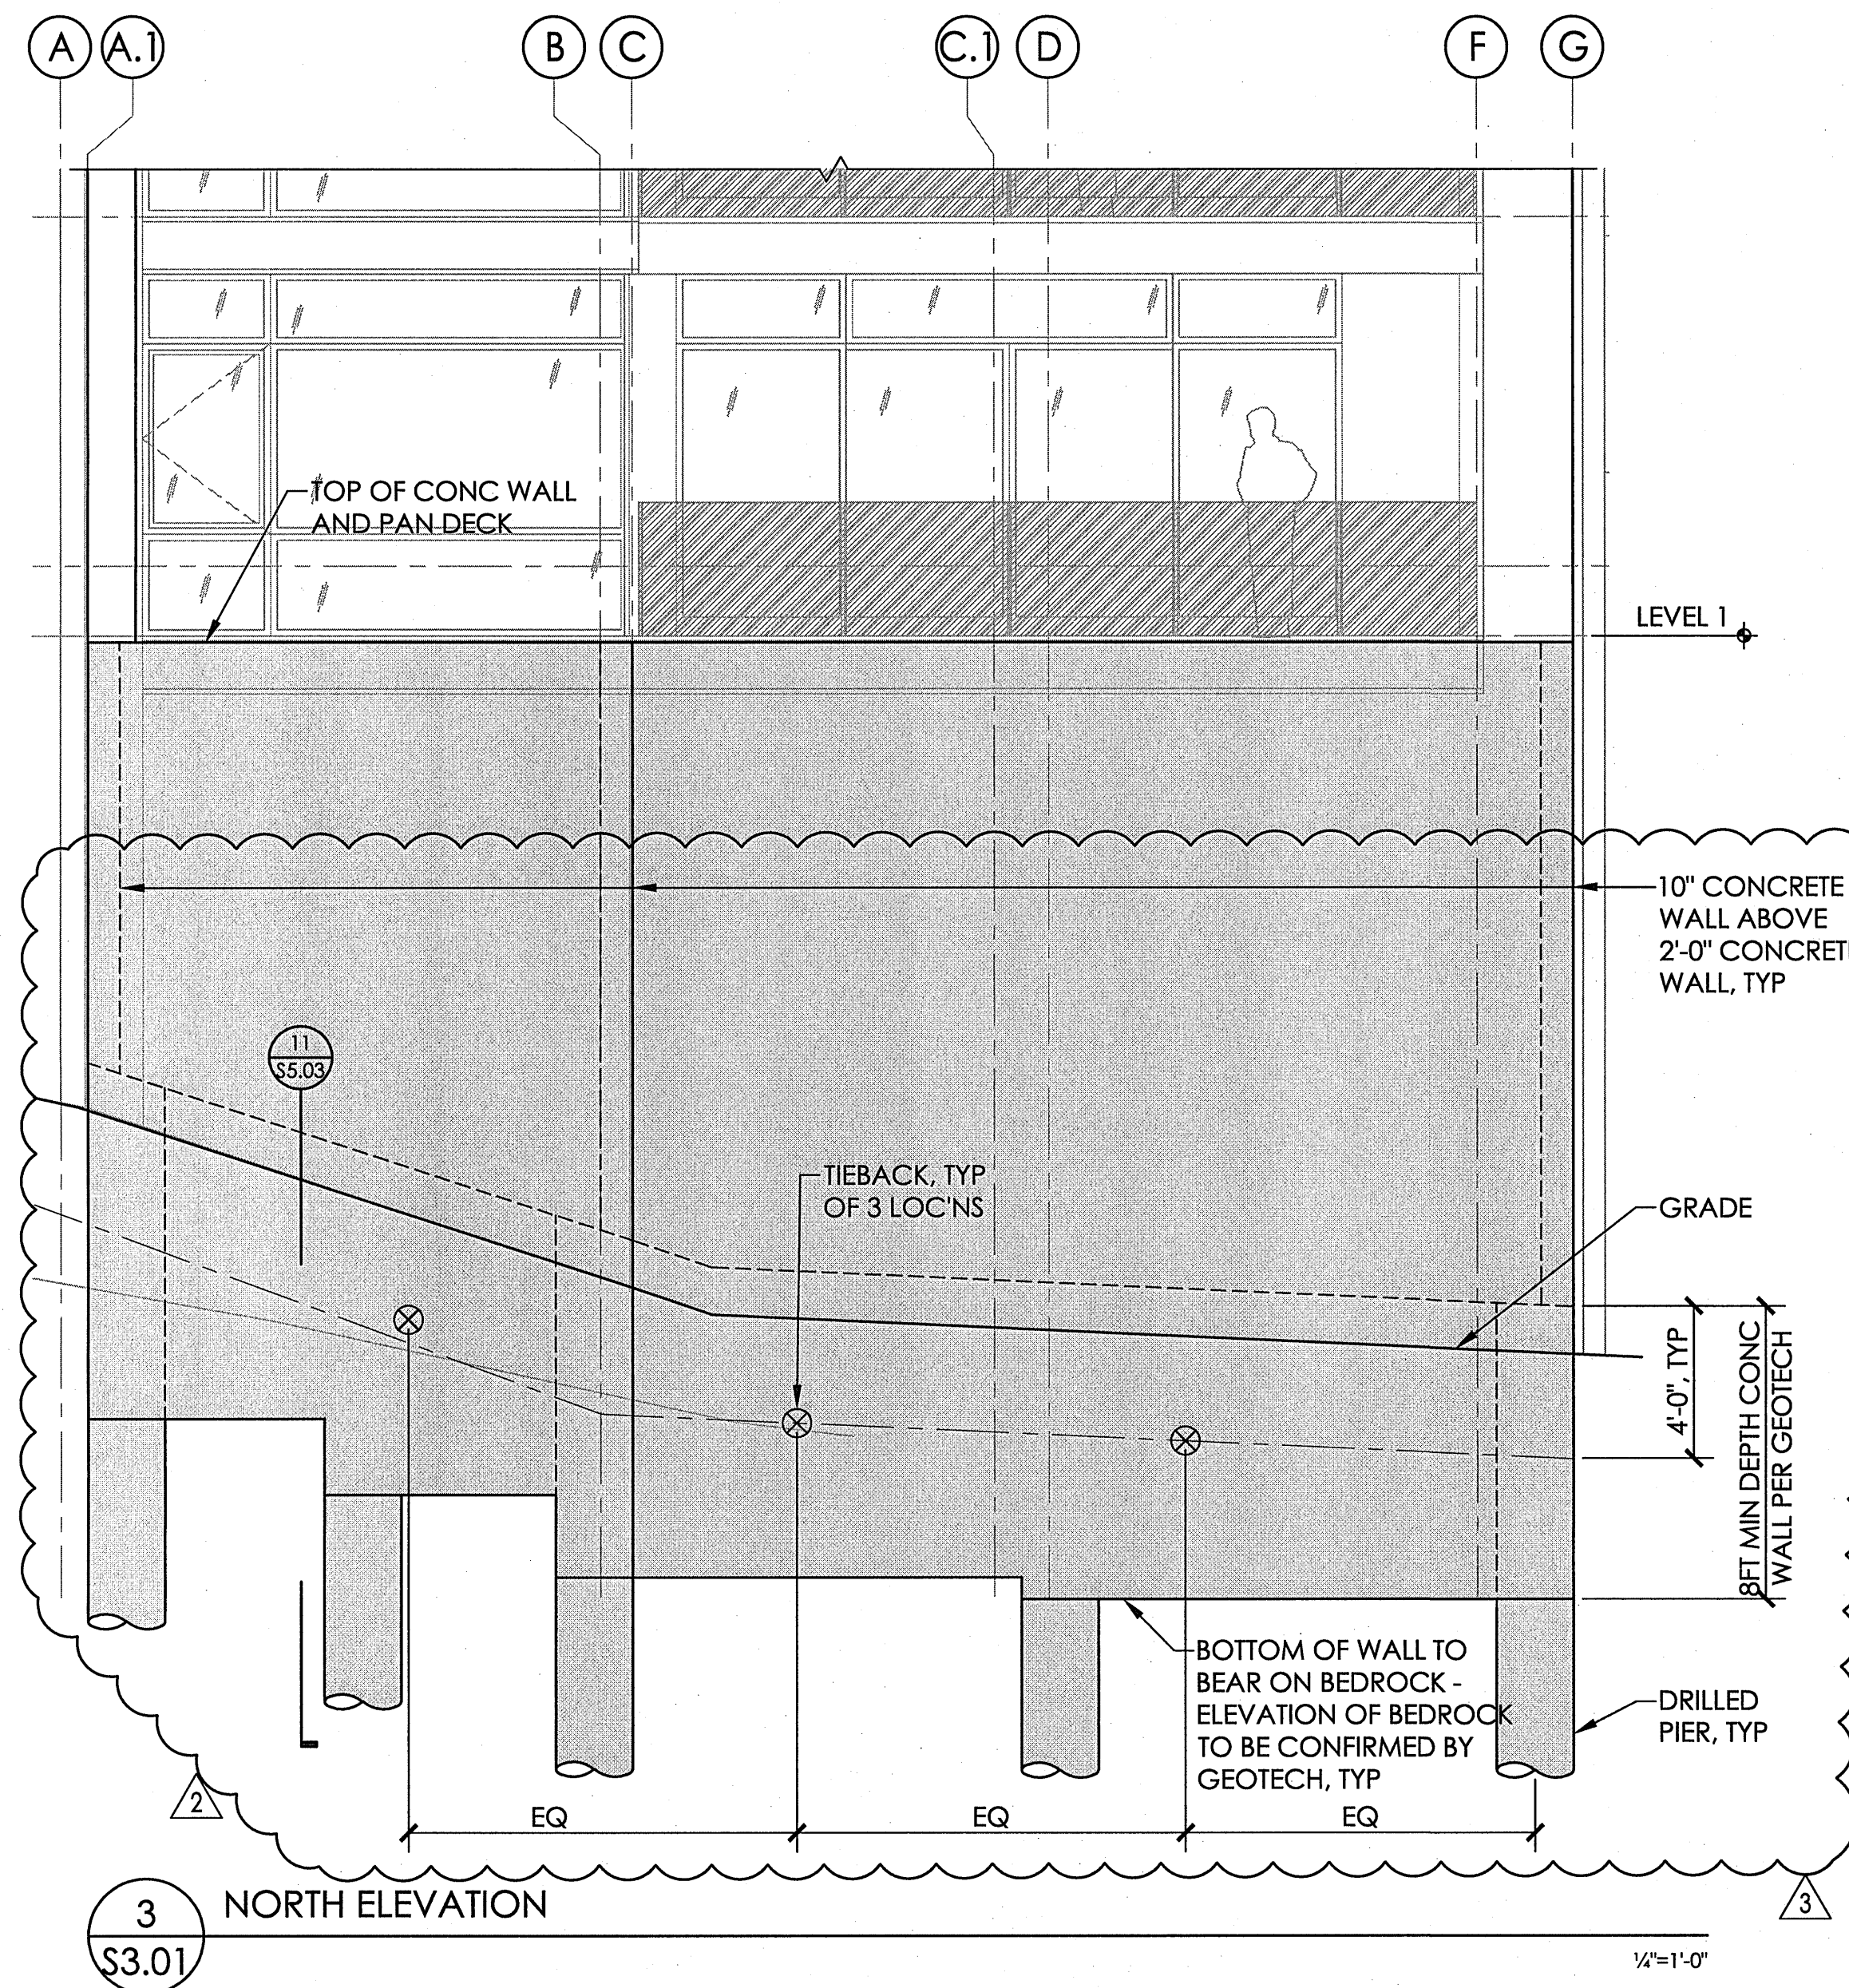


Chu Liu, DBI
JAN - 6 2022

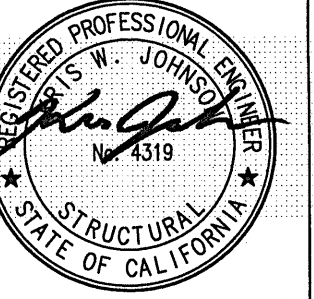

HART HOWERTON
NEW YORK - SAN FRANCISCO
One Union Street, San Francisco, CA 94111
Tel : 415 439 2200 Fax : 415 439 2201
Email : S@harthowerton.com

Structural
design for fine
architecture™
98 Green Street, Third Floor
San Francisco, California 94111
415 512 1201
G F D S
ENGINEERS

Reilly Residence
Sea Cliff
870 El Camino Del Mar
San Francisco, CA

© Hart Howerton 2017
The designs and concepts shown are the sole property of Hart Howerton and may not be used without the prior written consent of Hart Howerton.

SCALE : AS NOTED
NOTE: THIS DRAWING IS PLotted IN METRIC. ALL DIMENSIONS SHALL BE IN METRIC UNLESS OTHERWISE NOTED. DIMENSIONS IN INCHES SHALL BE CONSIDERED AS APPROXIMATE.

DATE	ISSUE
10/04/2019	PERMIT ADDENDUM

REVISIONS		
NO	DATE	ISSUE
1	1/10/20	SAC REVS
2	6/18/20	PLAN CHECK
3	11/09/21	FDN REVISION

DRAWING TITLE:
**BUILDING
ELEVATIONS**

PROJECT # :
18009
DRAWN BY :
CHK
CHECKED BY :
RWR

DRAWING NO :
S3.01