
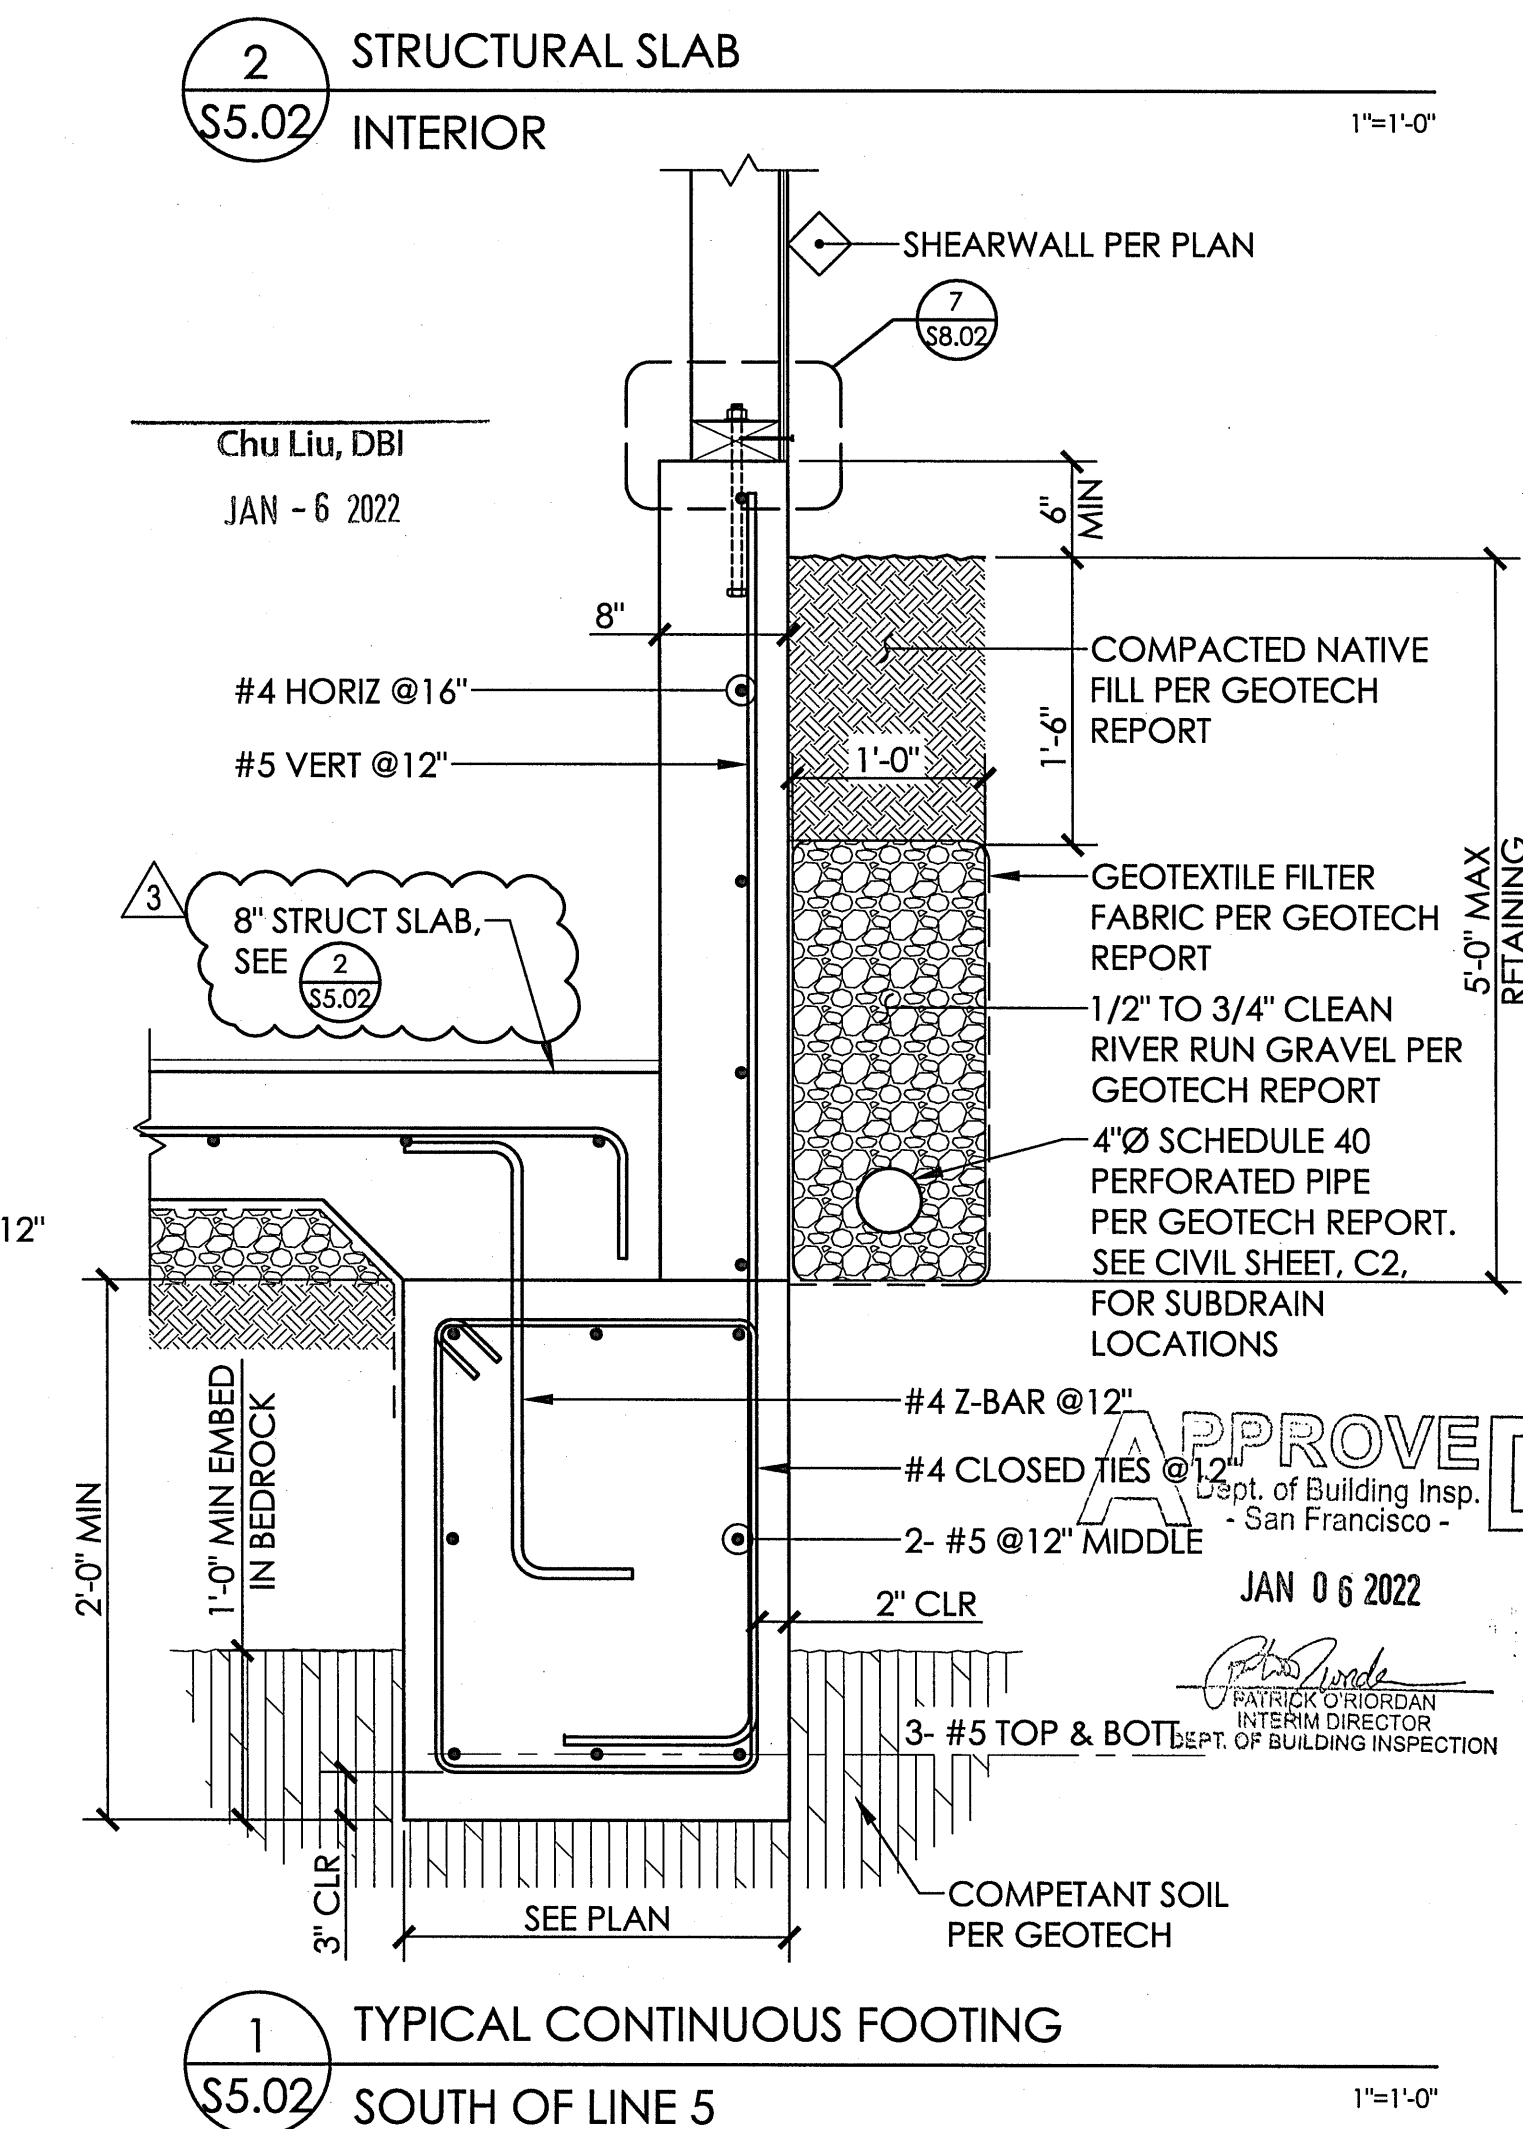
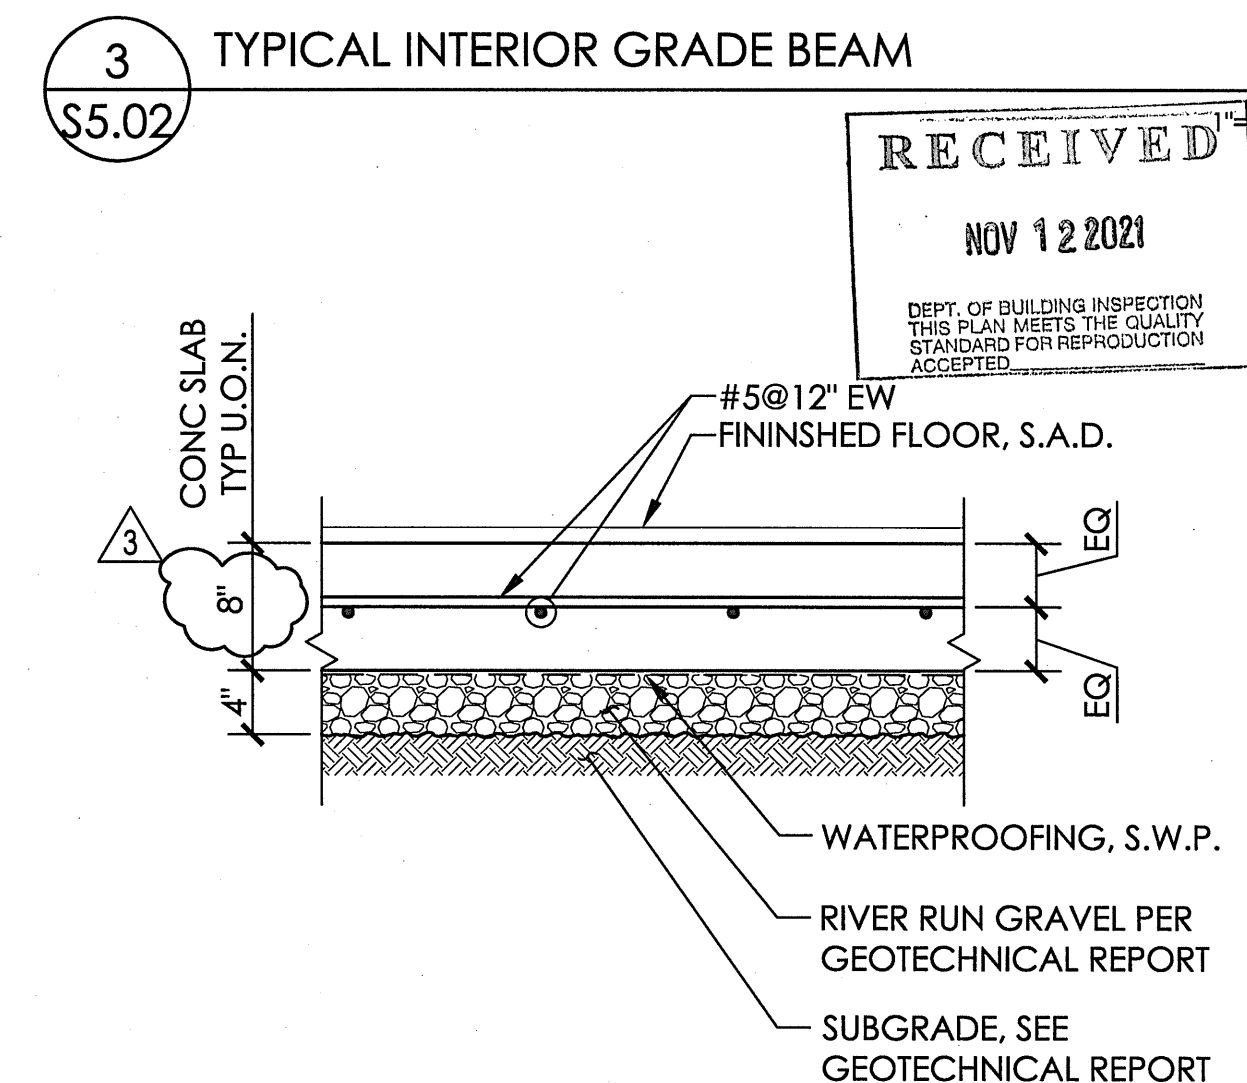
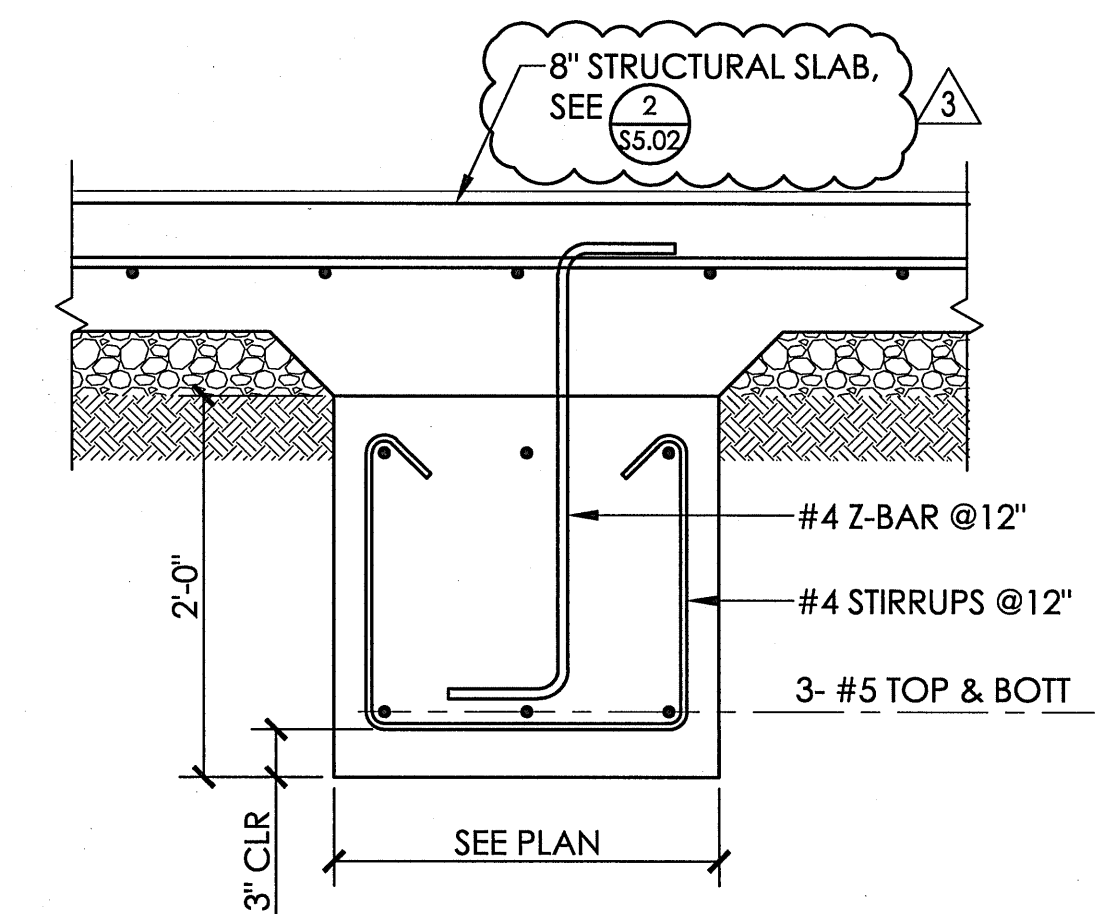
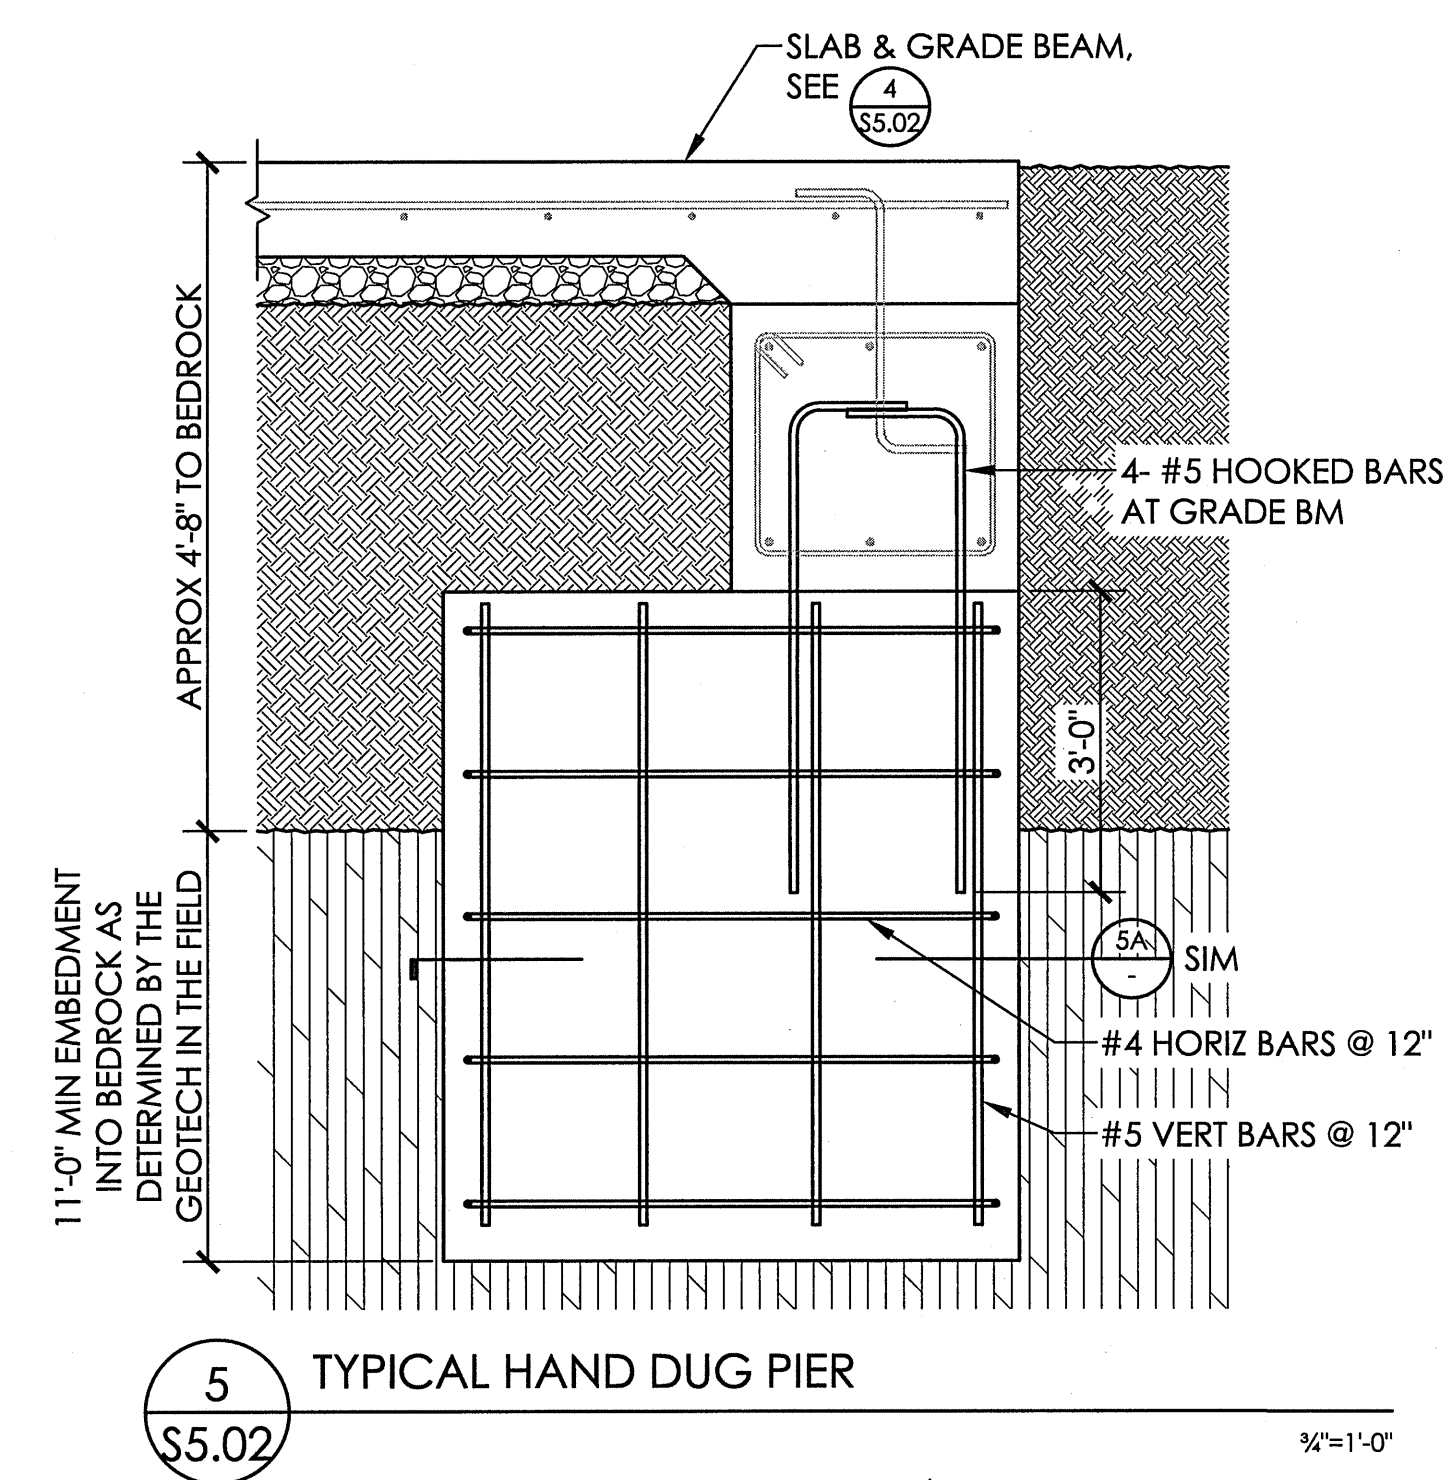
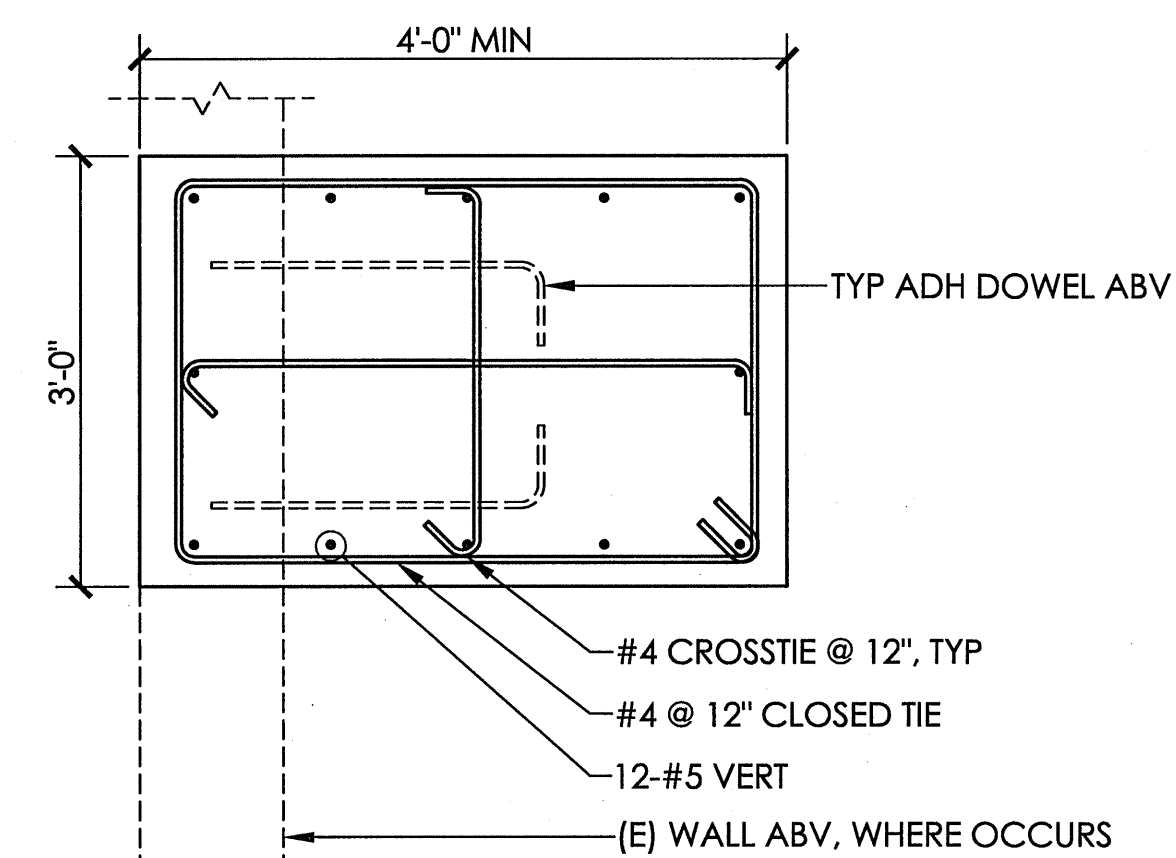
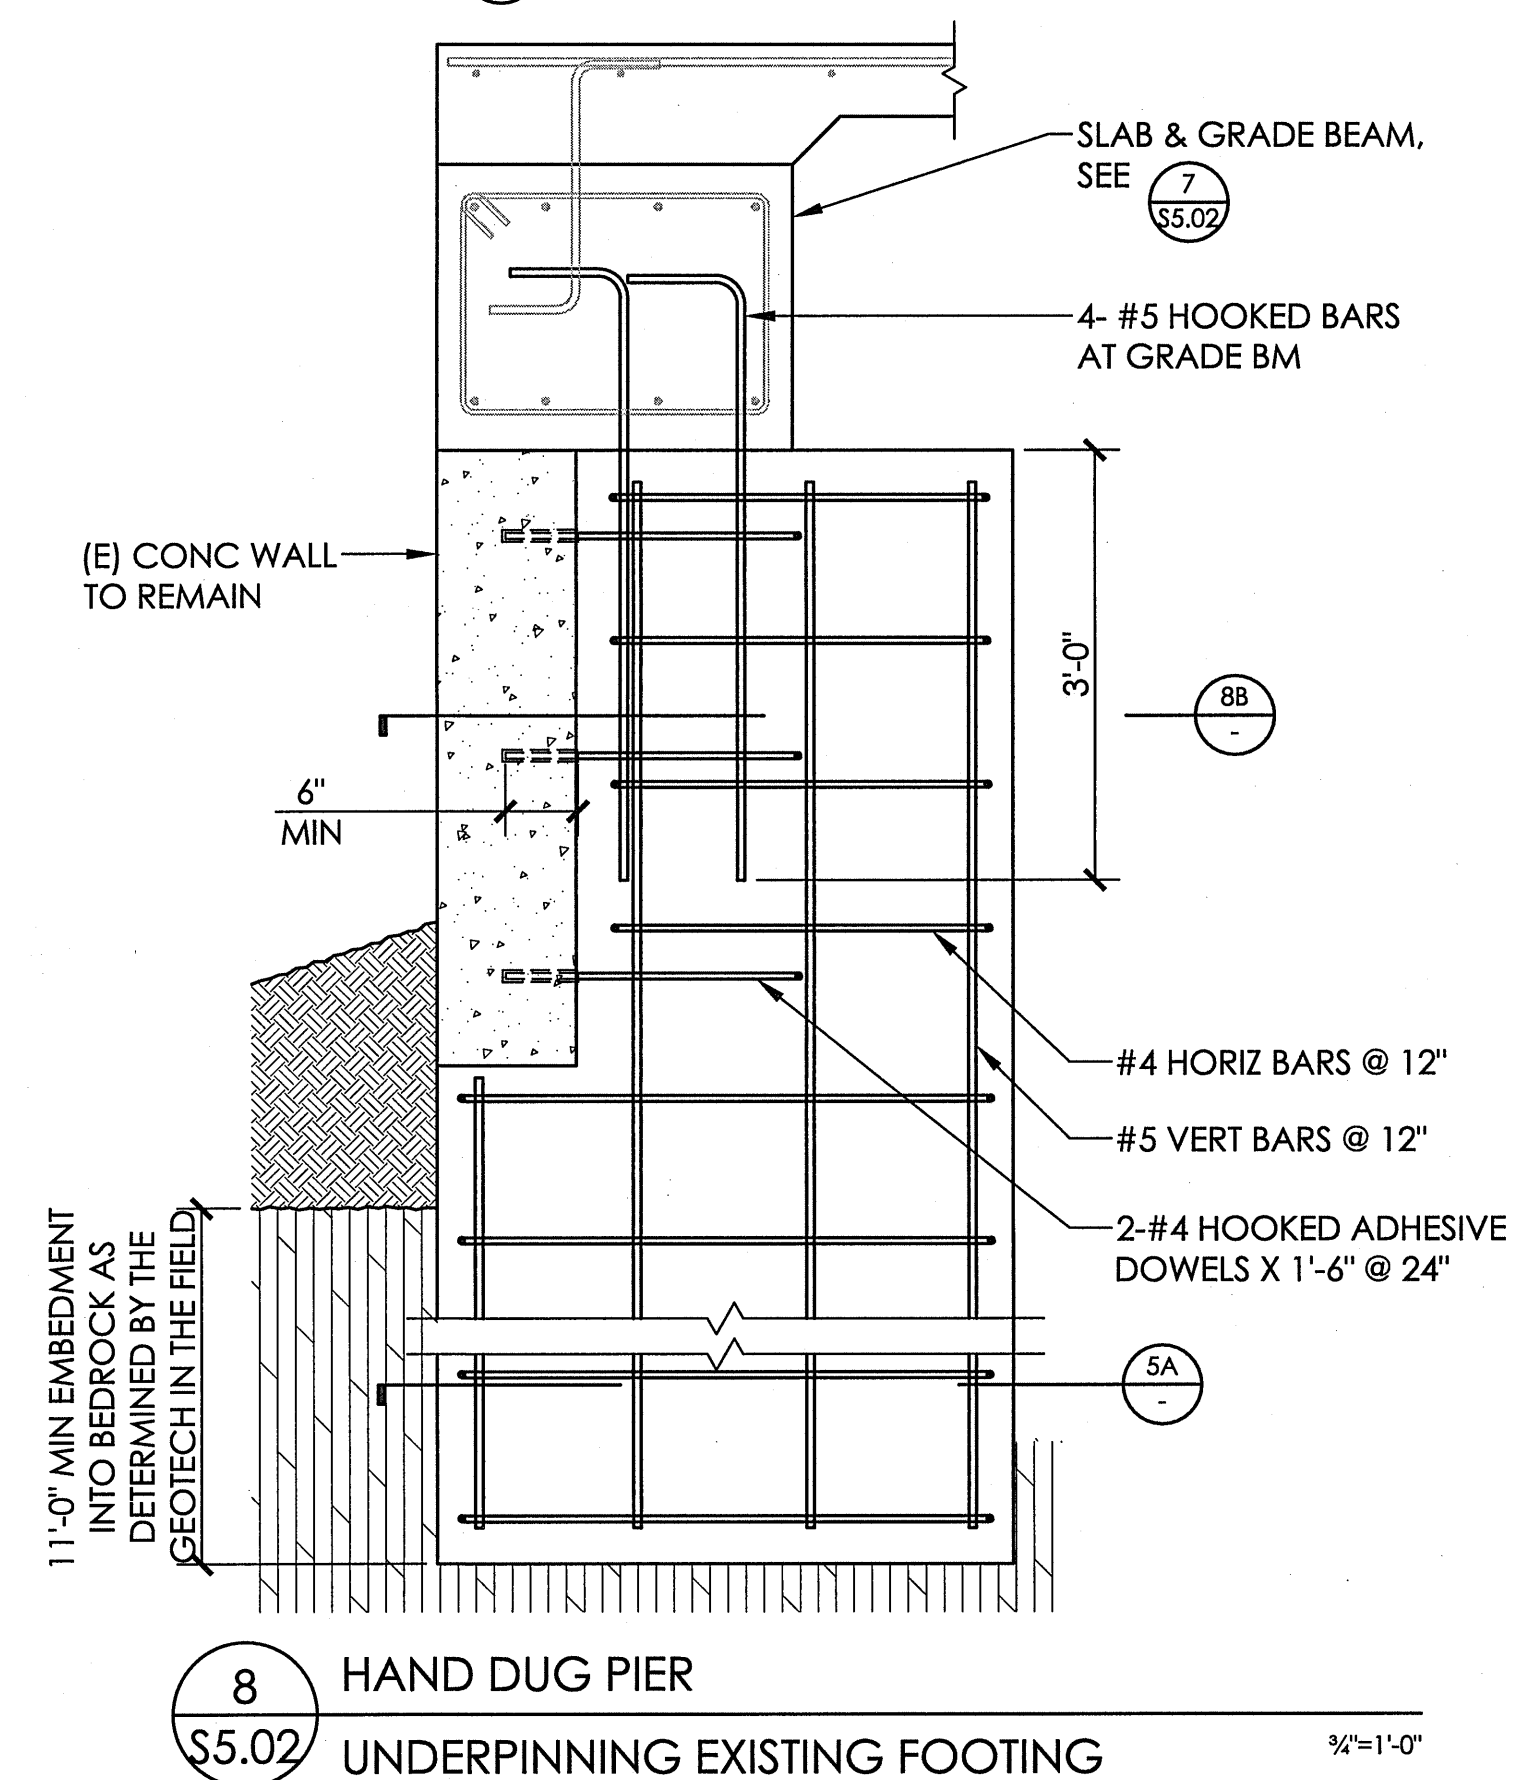
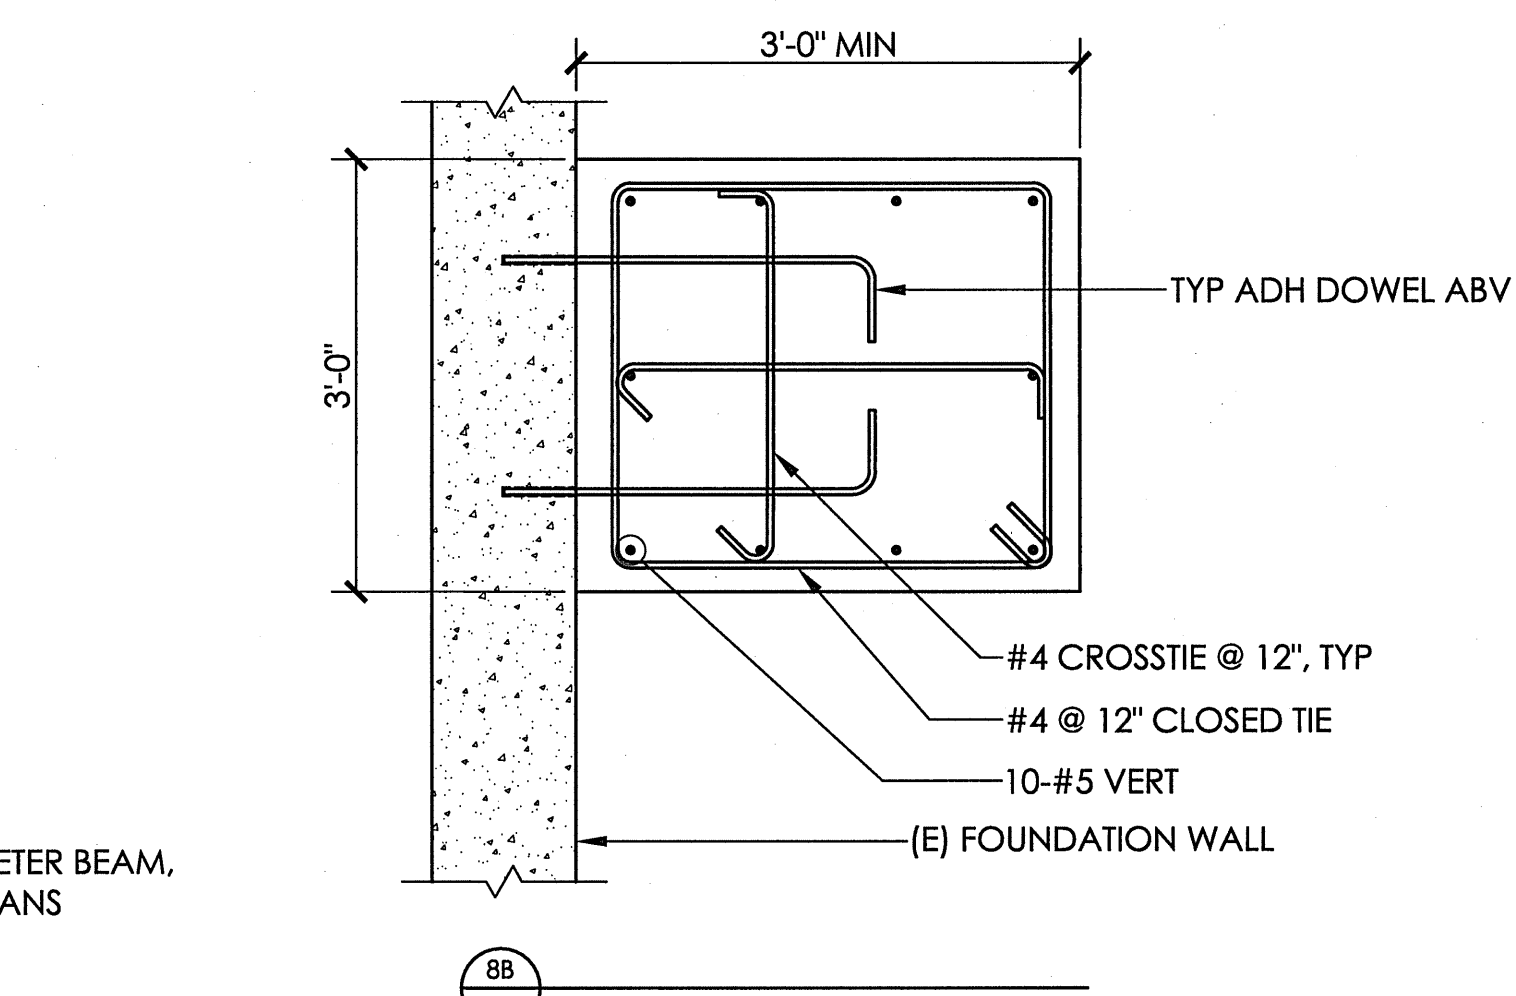
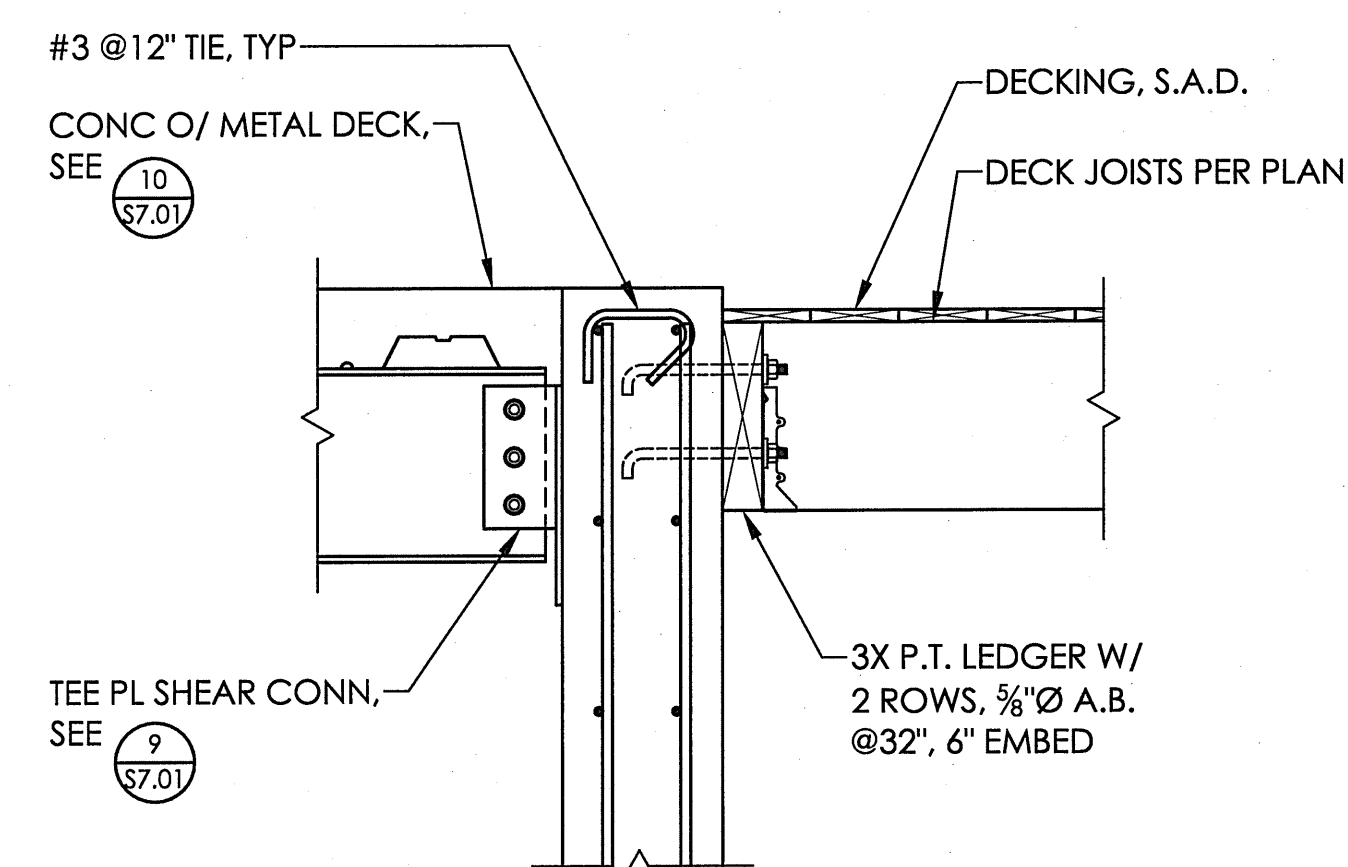


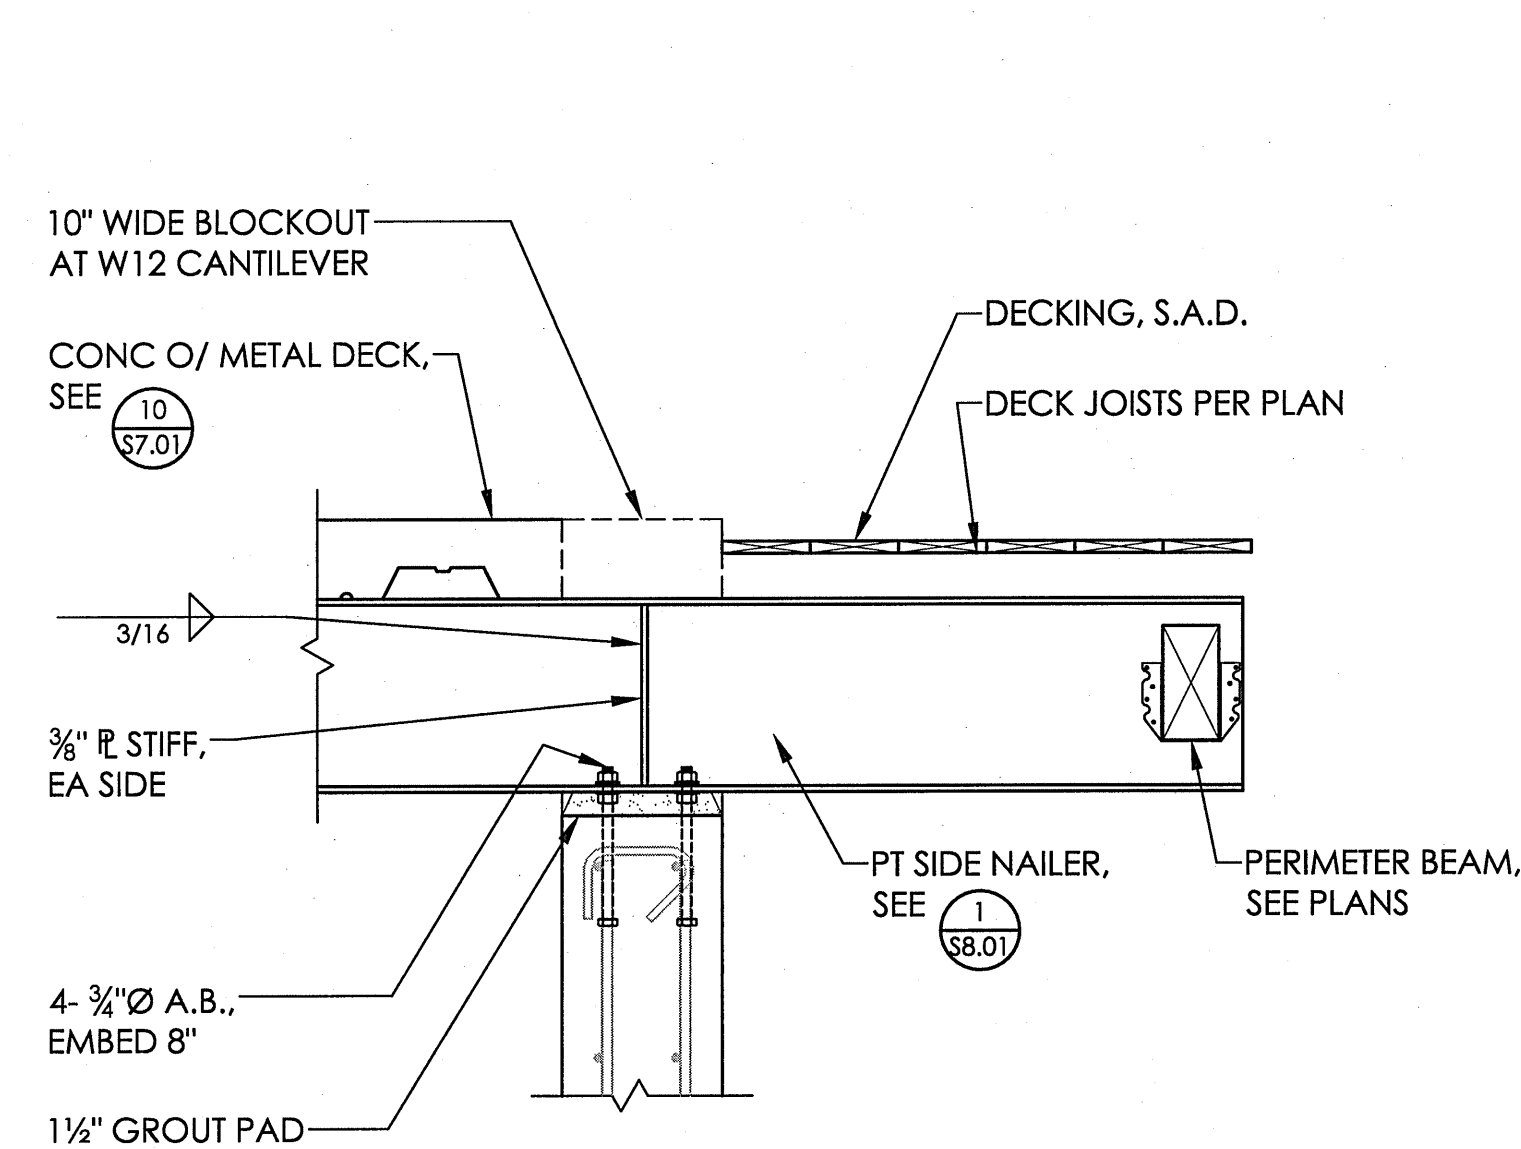

REGISTERED PROFESSIONAL ENGINEER
W. JOHNSON
No. 4319
STRUCTURAL
STATE OF CALIFORNIA

HART HOWERTON
NEW YORK • SAN FRANCISCO

One Union Street, San Francisco, CA 94111
Tel.: 415 439 2200 Fax.: 415 439 2201
Email.: SF@harthowerton.com

**Structural
design for fine
architecture™**

99 Green Street, Third Floor
San Francisco, California 94111
415/512-1301

**GFSD
ENGINEERS**

Reilly Residence
Sea Cliff
870 El Camino Del Mar
Sausalito, CA 94965

© Hart Howerton 2017

S C A L E : AS NOTED NOTE: THIS DRAWING IS 24"x36". DO NOT SCALE DRAWINGS. USE FIGURED DIMENSIONS ONLY, OR SPEC CLARIFICATIONS FROM ARCHITECT FOR MEASUREMENTS THAT ARE NOT INDICATED.	
D A T E	I S S U E
10/04/2019	PERMIT ADDED

R E V I S I O N S		
NO	DATE	ISSUE
1	1/10/20	SAC REVS
2	6/18/20	PLAN CHECK
3	11/09/21	FDN REVISION

DRAWING TITLE:	CONCRETE	
	DETAILS	

PROJECT # :
18009
DRAWN BY :
xxx
CHECKED BY :
RWR
DRAWING NO :
S5.02