CA 94065 (FAX)

255 SHORLINE DI REDWOOD CITY, ( 650/482-6300 650/482-6399 (

66

1 of 1

MCINITY MAP

PLOT (

REFERENCED PRELIMINARY REPORT FOR TITLE INSURANCE:

First American Title Company 1737 North First Street, Suite 500 San Jose, CA 95112

NATURE OF TITLE: Fee Simple as to Parcel ONE, an easement as to Parcel TWO

PROPERTY ADDRESS 11965 San Pablo Avenue El Cerrito, CA 94530

ZONING-CC (Community Commercial)
Per City of El Cerrito Zoning Map prepared Feb. 2008.

BEING A PORTION OF THAT CERTAIN PARCEL OF LAND DESCRIBED "FRST" IN DEED DATED MOVEMBER 23, 1964, TO GALLANG AND EAST SIZE RALEGAD COMPANY, BOOKDOOR DATED AND THE ADMINISTRATION OF THE ADMINISTRATION

BECONDING OF THE PARCEL TO BE DESCRIBED.

HENCE FROM SAD DOINT OF BEDDRING, CONTINUED, ALANO, SAD CURVE, THROUGH AN ANGLE OF 0'3 0'20", AN ARC DISTANCE OF 316.02 FEET TO THE PARCEL DESCRIBED IN THE SEED TO BE ALL STATES IN THE SEED THE SE

- 5. The Terms, Provisions and Easement(s) contained in the document entitled Croat of Drindage Easement recorded November 25, 1998 as instrument No. PLOTED
  POTED TO TECH TO THE CONTRACT OF THE CONTRACT OF THE CONTRACT OF T
- An easement for TEMPORARY CONSTRUCTION EASEMENT and incidental purposes, recorded DECEMBER 08, 2009 as INSTRUMENT NO. 2009-0288455-00 of Official Records.

In Favor of: SAN FRANCISCO BAY AREA RAPID TRANSIT DISTRICT,
A RAPID TRANSIT DISTRICT

Affects: as described therin Affects: PLOTTED

# BASIS OF BEARINGS:

The bearing of N28°01'41" between two found monuments on San Poblo Avenue, as shown on SFBART Right-of-Way Map "RRW46", dated March 24, 1965, was taken as the basis of bearings for this map.

# UTILITY NOTE:

The utilities shown on this plan are derived from surface observations and are approximate only. No warranty is implied as to the actual location, size or presence of any additional utilities not shown on this plan.

# ALTA SURVEY NOTES:

- The BOLD THPE comments are added by the professional land surveyor.

  The BOLD THPE comments are added by the professional land surveyor.

  Dimensional ties to improvements are 80° to the property lines unless noted. In or out as shore on this survey indicate the distance inside or outside of the subject property or experience.

  Supermount 16, 2014. This survey does not constitute on ALTA performed on each individual Parcel.

  The total orea of lands shown by the distinctive property line = 22,260 SQT. or 0.53 AMPESA.


# SURVEYOR'S STATEMENT:

To: BCCI Development, LLC and First American Title Company.

This is to certify that this map or plot and the survey on which it is based were made in accordance with the 2011 Minimum Standard Detail Requirements for ALTA/ACSA LAOT fillse Surveys, jointly established and adopted by ALTA and NSPS, and includes optional items 2, 4, 6(a), 8, 11(a), 13 and 14 of Table A thereof. The field work was completed on September 16, 2014.

Alex M. Calder, LLS 8883



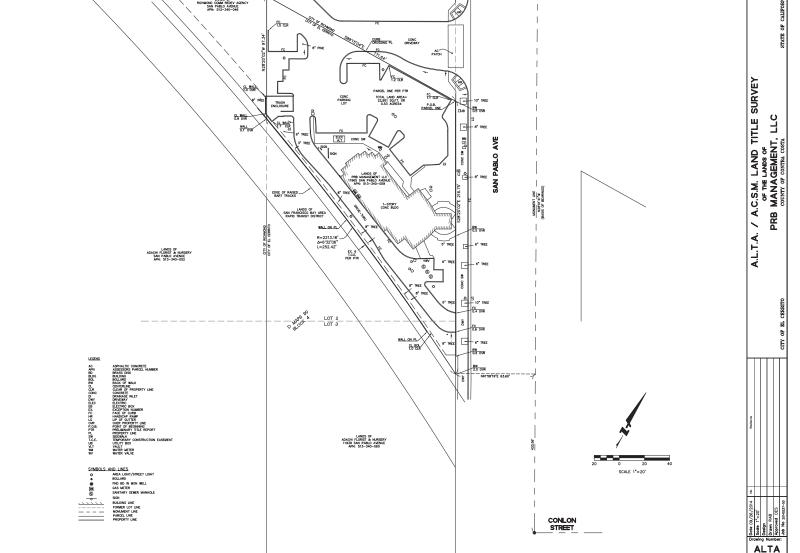

LANDS OF RICHMOND COMM REDEV AGENCY SAN PABLO AVENUE APN: 513-340-046

PARCEL TW EX. 5 DRAINAGE EASEMENT PER PTR

TITLE COMPANY: ORDER NO: DATE OF REPORT:

NCS-688732-SC August 21, 2014

TITLE VESTED IN: PRB Management, LLC, a California limited liability company

513-340-059-7

### LEGAL DESCRIPTION:

Real property in the City of EL CERRITO, County of Contra Costa, State of California, described as follows:

### PARCEL ONE:

PORTIONS OF LOTS 2 AND 3, IN BLOCK 4 AS SHOWN ON THE "AMENDED MAP OF ALTA PUNTA TRACT", FILED APRIL 22, 1905, IN BOOK D OF MAPS, PAGE 90 IN THE OFFICE OF THE COUNTY RECORDER OF CONTRA COSTA COUNTY, DESCRIBED AS FOLLOWS:

### PARCEL TWO:

A NON-EXCLUSIVE EASEMENT FOR STORM DRAINAGE PURPOSES CREATED AS AN APPURTENANCE TO PARCEL ONE ABOVE THE THE GRANT OF DRAINAGE EASEMENT IN FAVOR OF PHIL SINGH BASRA, ET UX, RECORDED NOVEMBER 25, 1988, SERIES NO. 98-296249, DESCRIBED AS FOLLOWS:

OGMENON AT THE INTERSECTION OF THE NORTHEAST LINE OF LOT 3 IN BLOCK A 55 SHOWLOOF SOLD MAY (OU NO) WITH THE WORTH LINE OF THE THREES, OF THE THREE OF THE THREE OF THE THREE OF THRE

APN: 513-340-059-7 PLOTTED